


SEE SHEET 0473-BLOCK 3 PP8





SEWER STRUCTURE TABLE					
STRUCTURE #	OPSD	OPSD COVER	RIM ELEV	INV IN	INV OUT
1	701.010	401.010	190.28		SW 187.15
2	705.010	RYCB	189.32		NW 186.52 NE 186.52
3	701.013	Standard	189.68	SE 186.50 S 186.51	
CB 9	705.010	401.040	188.21	SE 186.55	NE 186.55
DI 7	705.040	TYPE A	187.38		N 186.56 S 186.64
HW 6	804.040		188.35	NW 186.60	
HW 8	804.030		187.94	NE 187.02	





AS CONSTRUCTED PLAN

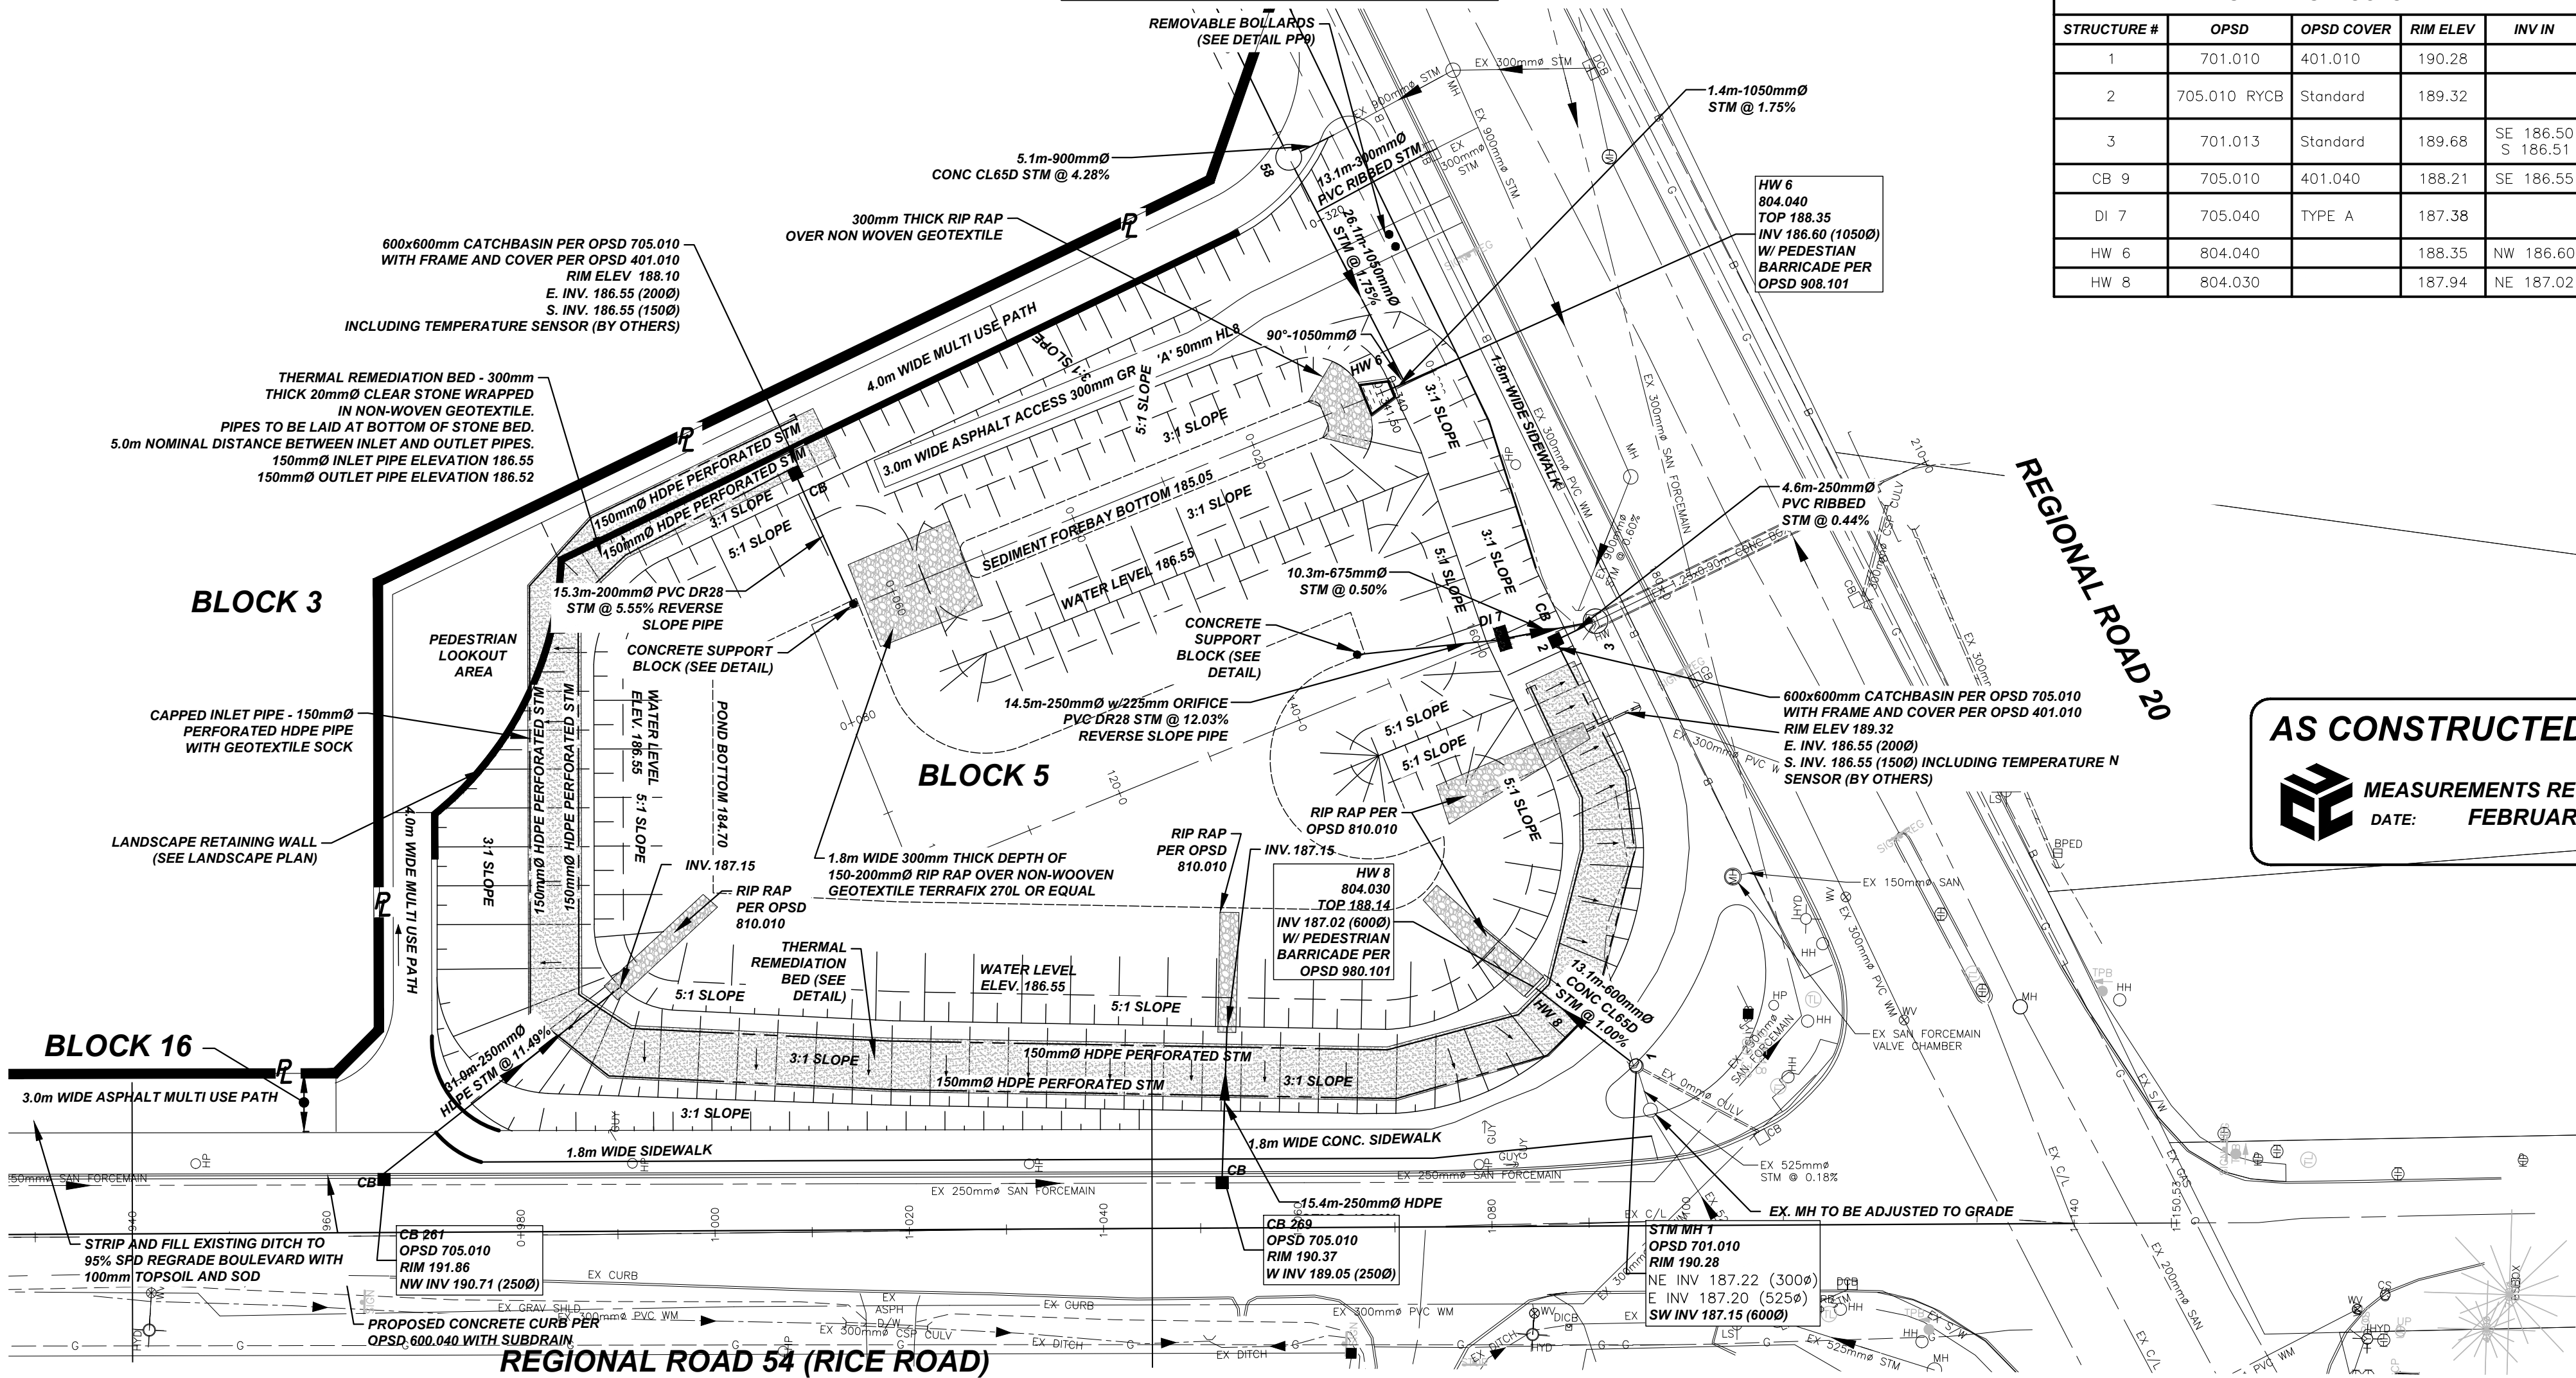

MEASUREMENTS RECORDED:
DATE: FEBRUARY 5, 2018

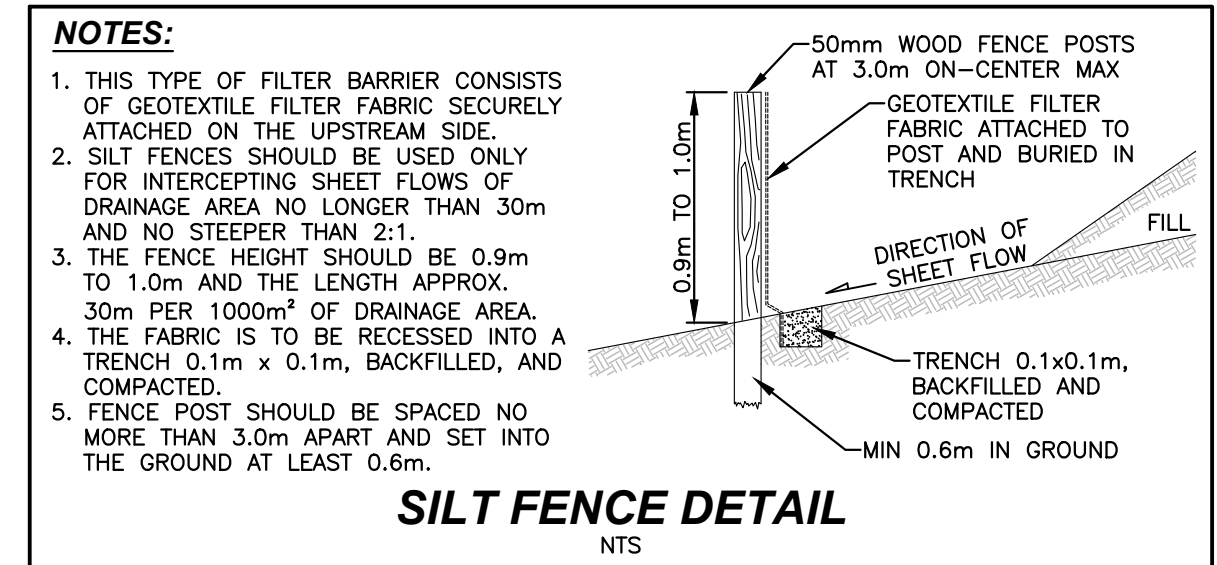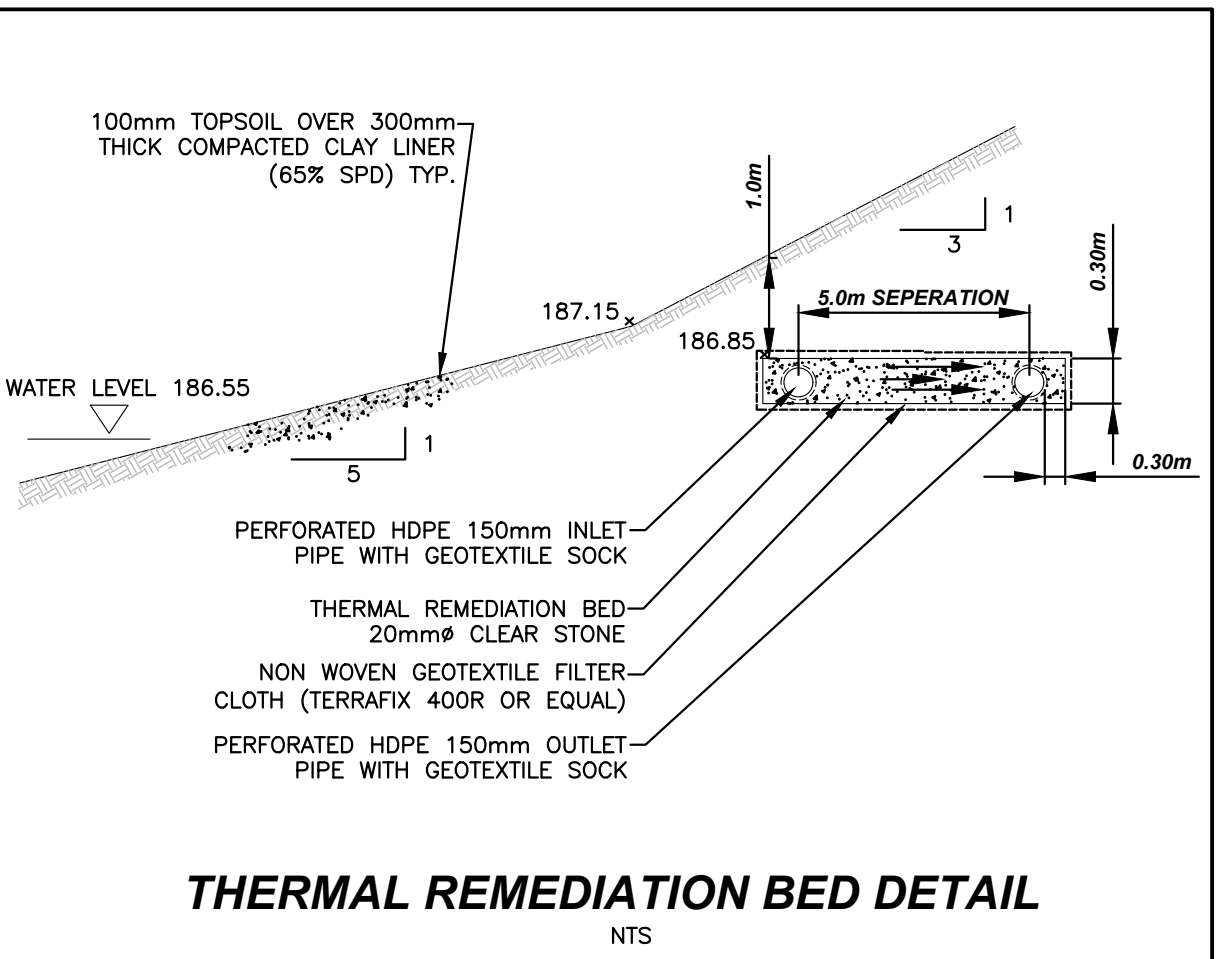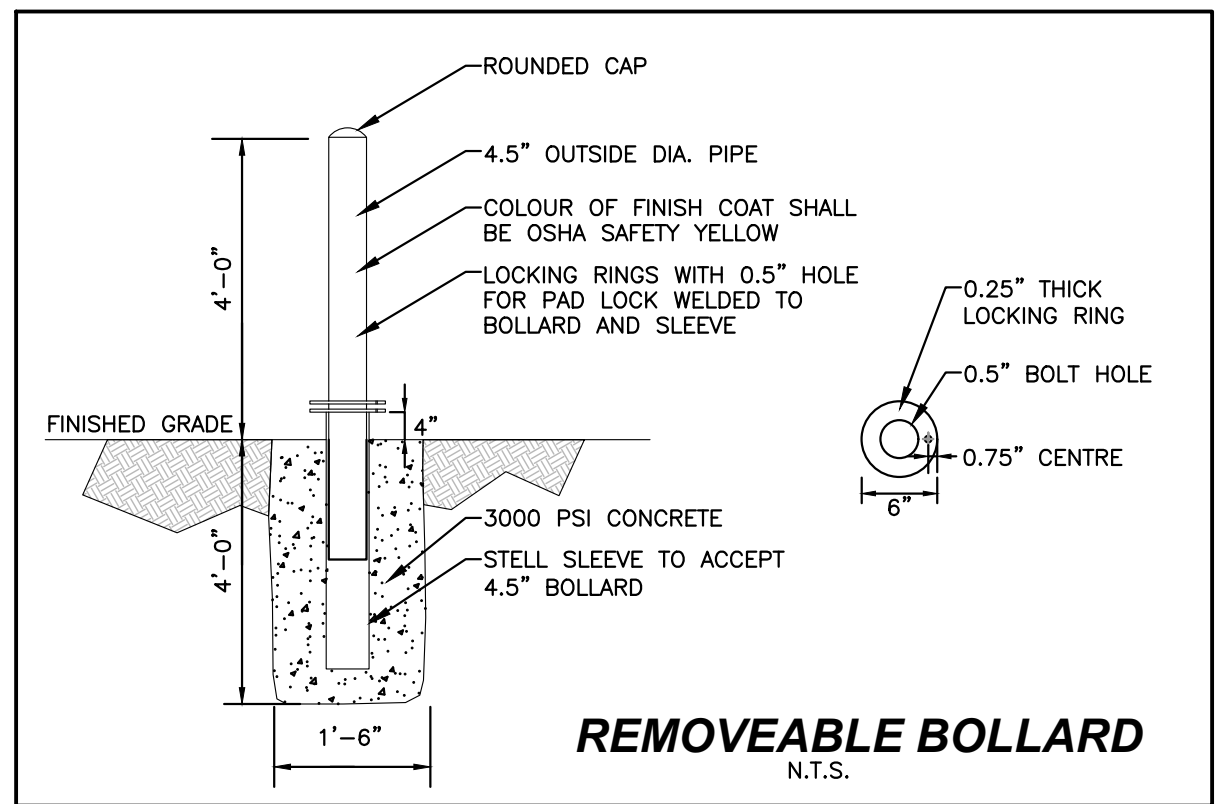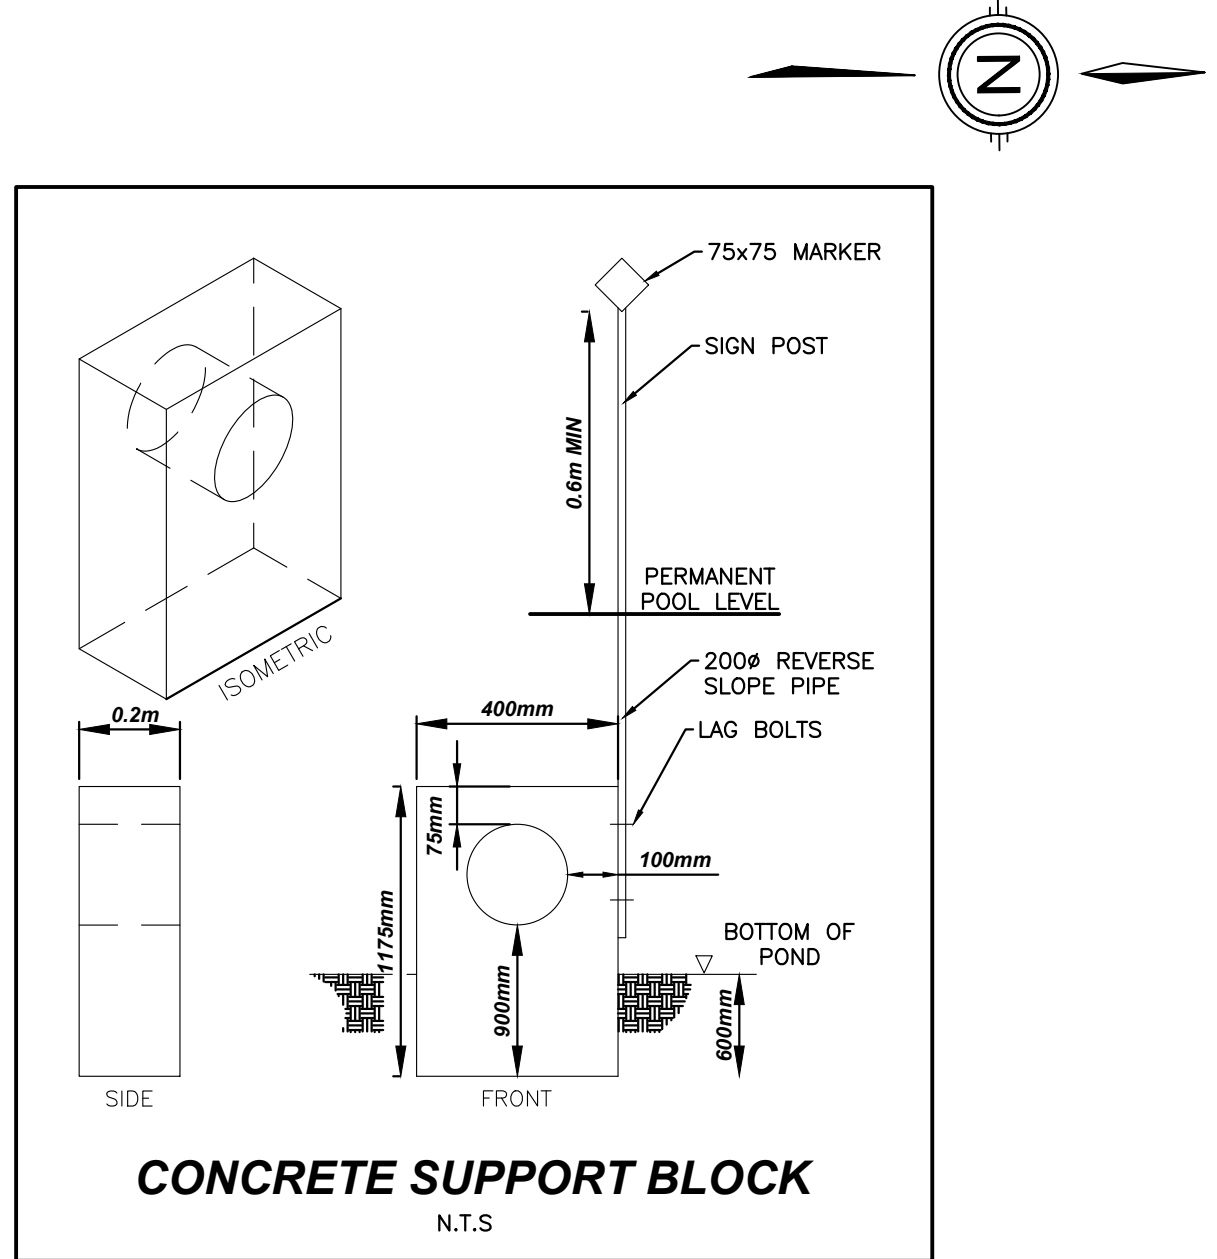

- NOTES:
- THIS TYPE OF FILTER BARRIER CONSISTS OF GEOTEXTILE FILTER FABRIC SECURELY ATTACHED ON THE UPSTREAM SIDE.
 - SILT FENCES SHOULD BE USED ONLY FOR INTERCEPTING SHEET FLOWS OF DRAINAGE AREA NO LONGER THAN 30m AND NO STEEPER THAN 2:1.
 - THE FENCE HEIGHT SHOULD BE 0.9m TO 1.0m AND THE LENGTH APPROX. 30m PER 1000m² OF DRAINAGE AREA.
 - THE FABRIC IS TO BE RECESSED INTO A TRENCH 0.1m x 0.1m, BACKFILLED, AND COMPACTED.
 - FENCE POST SHOULD BE SPACED NO MORE THAN 3.0m APART AND SET INTO THE GROUND AT LEAST 0.6m.

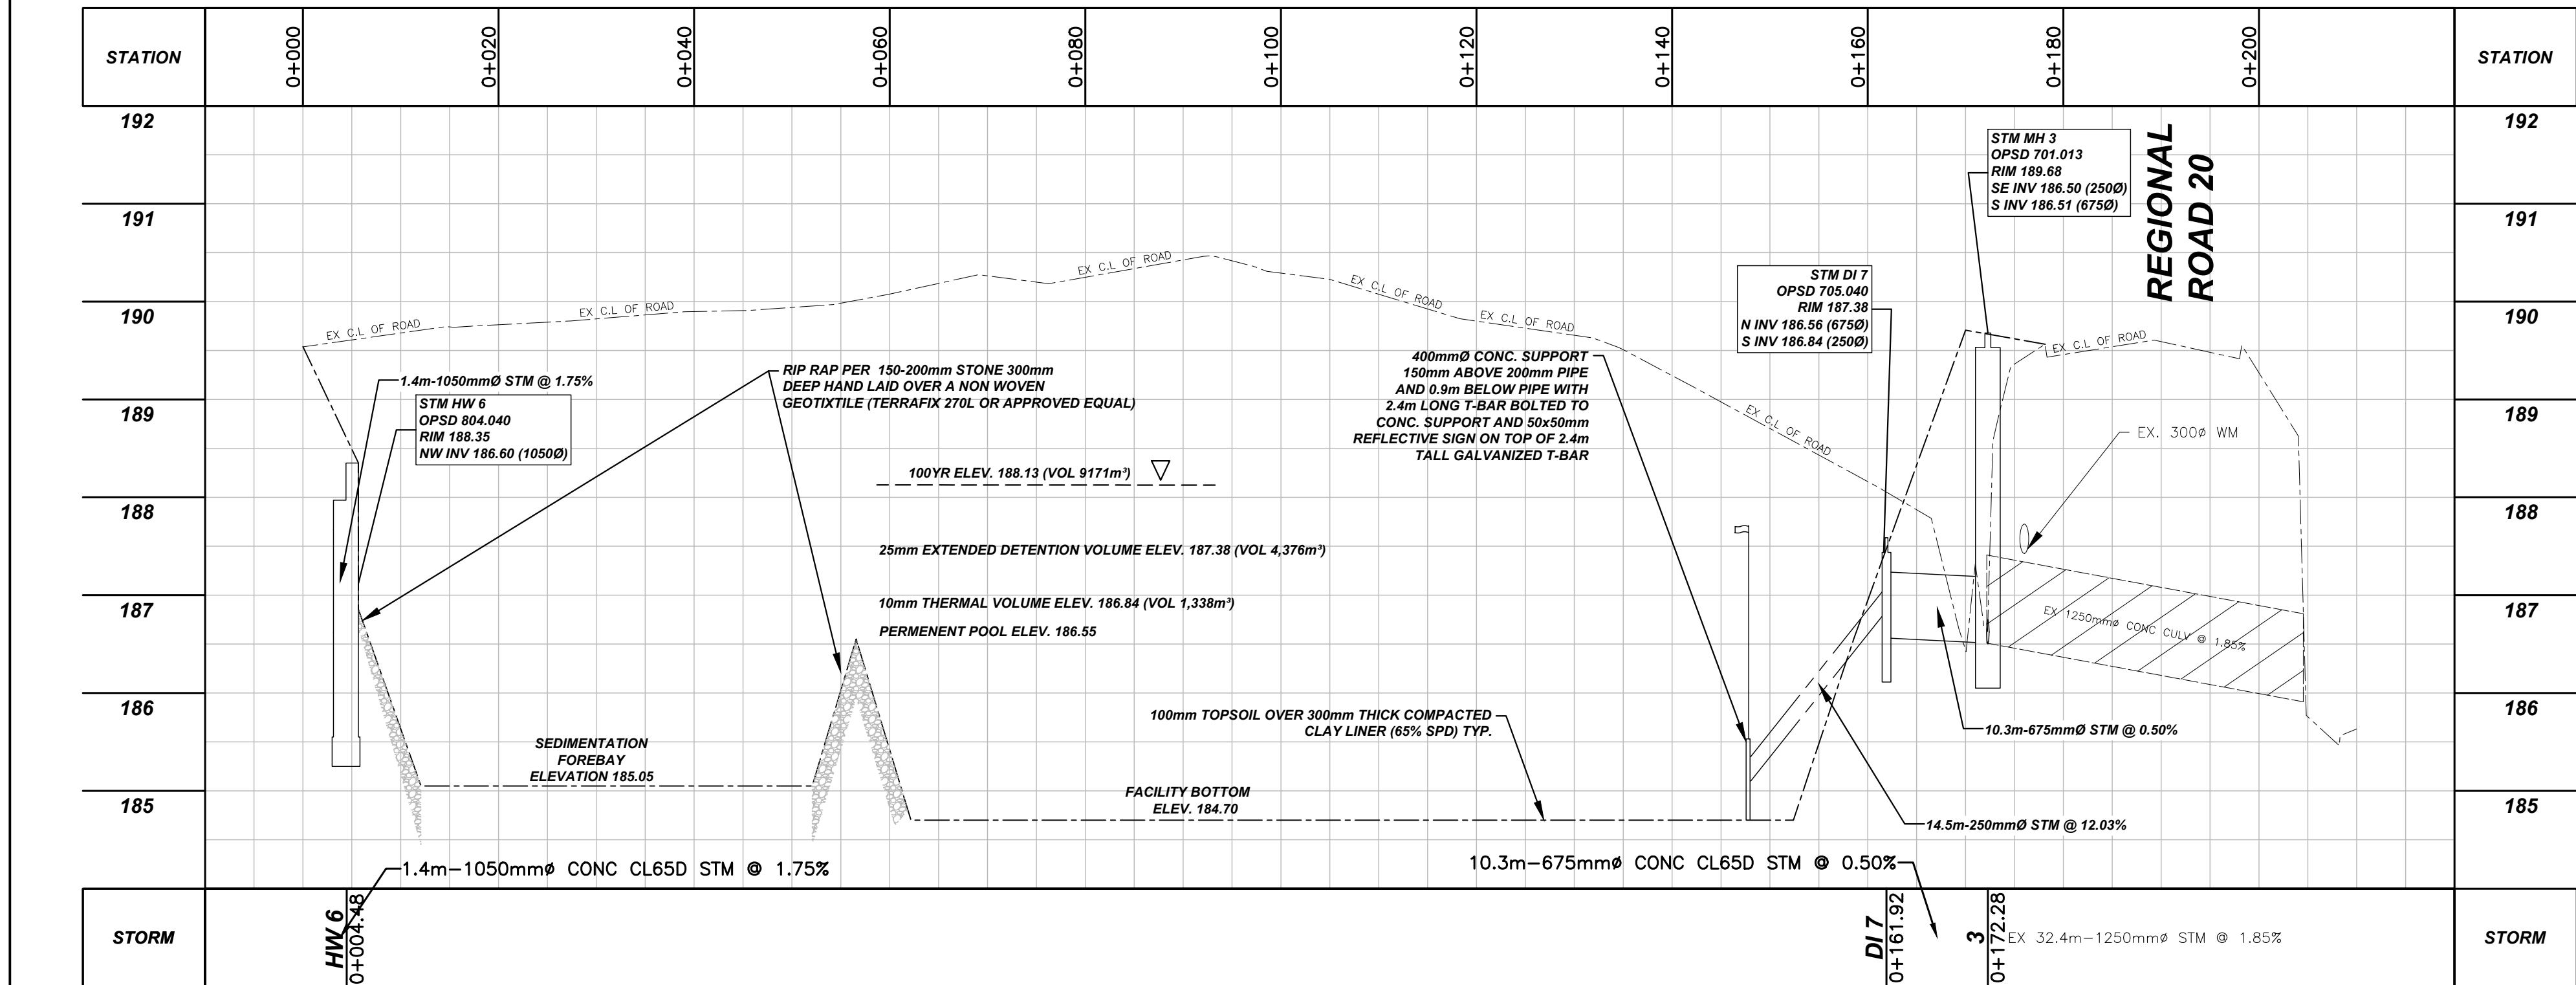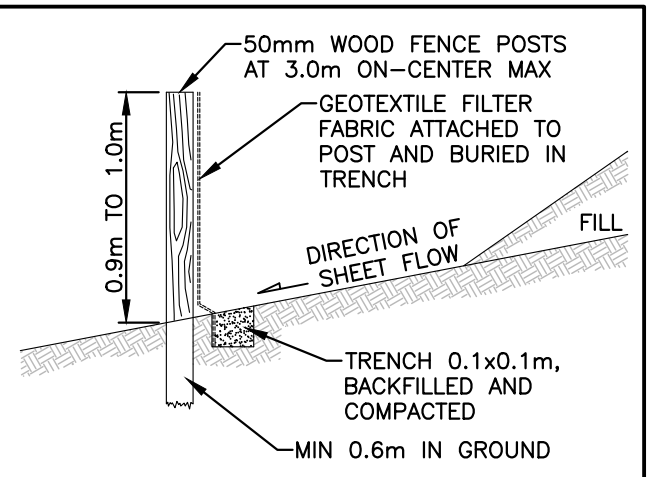

NO	REVISION	DATE	INIT
5	AS CONSTRUCTED	2018-02-06	J.C.
4	ISSUED FOR CONSTRUCTION	2015-06-08	M.C.
3	ISSUED FOR TENDER	2015-03-20	M.C.
2	REVISED PER REGIONAL COMMENTS	2015-03-05	M.C.
1	REVISED PER REGIONAL COMMENTS	2015-02-25	M.C.
0	ISSUED FOR MOE APPROVAL	2014-10-07	M.C.

- NOTES/LEGEND
- THE POSITION OF POLE LINES, CONDUITS, WATERMAINS, SEWER AND OTHER UNDERGROUND AND OVERGROUND UTILITIES AND STRUCTURES IS NOT NECESSARILY SHOWN ON THE CONTRACT DRAWINGS AND, WHERE SHOWN, THE ACCURACY OF THE POSITION OF SUCH UTILITIES AND STRUCTURES IS NOT GUARANTEED. BEFORE STARTING WORK, THE CONTRACTOR SHALL INFORM HIMSELF OF THE EXACT LOCATION OF ALL SUCH UTILITIES AND STRUCTURES AND SHALL ASSUME ALL LIABILITY FOR DAMAGE TO THEM.
 - PROPERTY LINES WERE PLOTTED USING REGISTERED PLANS AND BARS LOCATED IN THE FIELD. TO VERIFY THE ACCURACY OF THESE PROPERTY LINES, A LEGAL SURVEY SHOULD BE PERFORMED PRIOR TO CONSTRUCTION.
 - ALL CONSTRUCTION MUST COMPLY WITH THE NIAGARA PENINSULA STANDARD CONTRACT DOCUMENT.

DRAFTING	M.C.
DESIGN	A.K.
CHECKED BY	M.H.
APPROVED BY	A.K.

THE VILLAGE OF EAST FONTHILL
NORTH POND
PLAN AND PROFILE
FROM STA 0+000 TO STA 0+210.00
TOWN OF PELHAM

CONSULTANT FILE No. 0473	REV.
DATE 2015-06-08	4
SCALE 1 : 500m	
REF. No.	
DWG No.	0473PP9