




11	AS CONSTRUCTED	2018-01-03	JC
10	ISSUED FOR BUILDING PERMIT	2016-12-15	MH
9	REVISED PIPE SLOPES	2016-10-28	AK
8	REVISED DRIVEWAY LOCATIONS	2016-10-26	AK
7	REVISED PER TOWN COMMENTS, ISSUED FOR CONSTRUCTION	2016-07-19	AK
6	ISSUED FOR CONSTRUCTION	2016-06-28	AK
5	REVISED PER TOWN COMMENTS	2016-06-20	AK
4	REVISED PER TOWN COMMENTS	2016-06-07	AK
#	REVISION	DATE	INIT

- NOTES/LEGEND
1. THE POSITION OF POLE LINES, CONDUITS, WATERMAINS, SEWER AND OTHER UNDERGROUND AND OVERGROUND UTILITIES AND STRUCTURES IS NOT NECESSARILY SHOWN ON THE CONTRACT DRAWINGS AND, WHERE SHOWN, THE ACCURACY OF THE POSITION OF SUCH UTILITIES AND STRUCTURES IS NOT GUARANTEED. BEFORE STARTING WORK, THE CONTRACTOR SHALL INFORM HIMSELF OF THE EXACT LOCATION OF ALL SUCH UTILITIES AND STRUCTURES AND SHALL ASSUME ALL LIABILITY FOR DAMAGE TO THEM.
 2. PROPERTY LINES WERE PLOTTED USING REGISTERED PLANS AND BARS LOCATED IN THE FIELD. TO VERIFY THE ACCURACY OF THESE PROPERTY LINES, A LEGAL SURVEY SHOULD BE PERFORMED PRIOR TO CONSTRUCTION.
 3. ALL CONSTRUCTION MUST COMPLY WITH THE NIAGARA PENINSULA STANDARD CONTRACT DOCUMENT.

DRAFTING	TC
DESIGN	AK
CHECKED BY	MH
APPROVED BY	

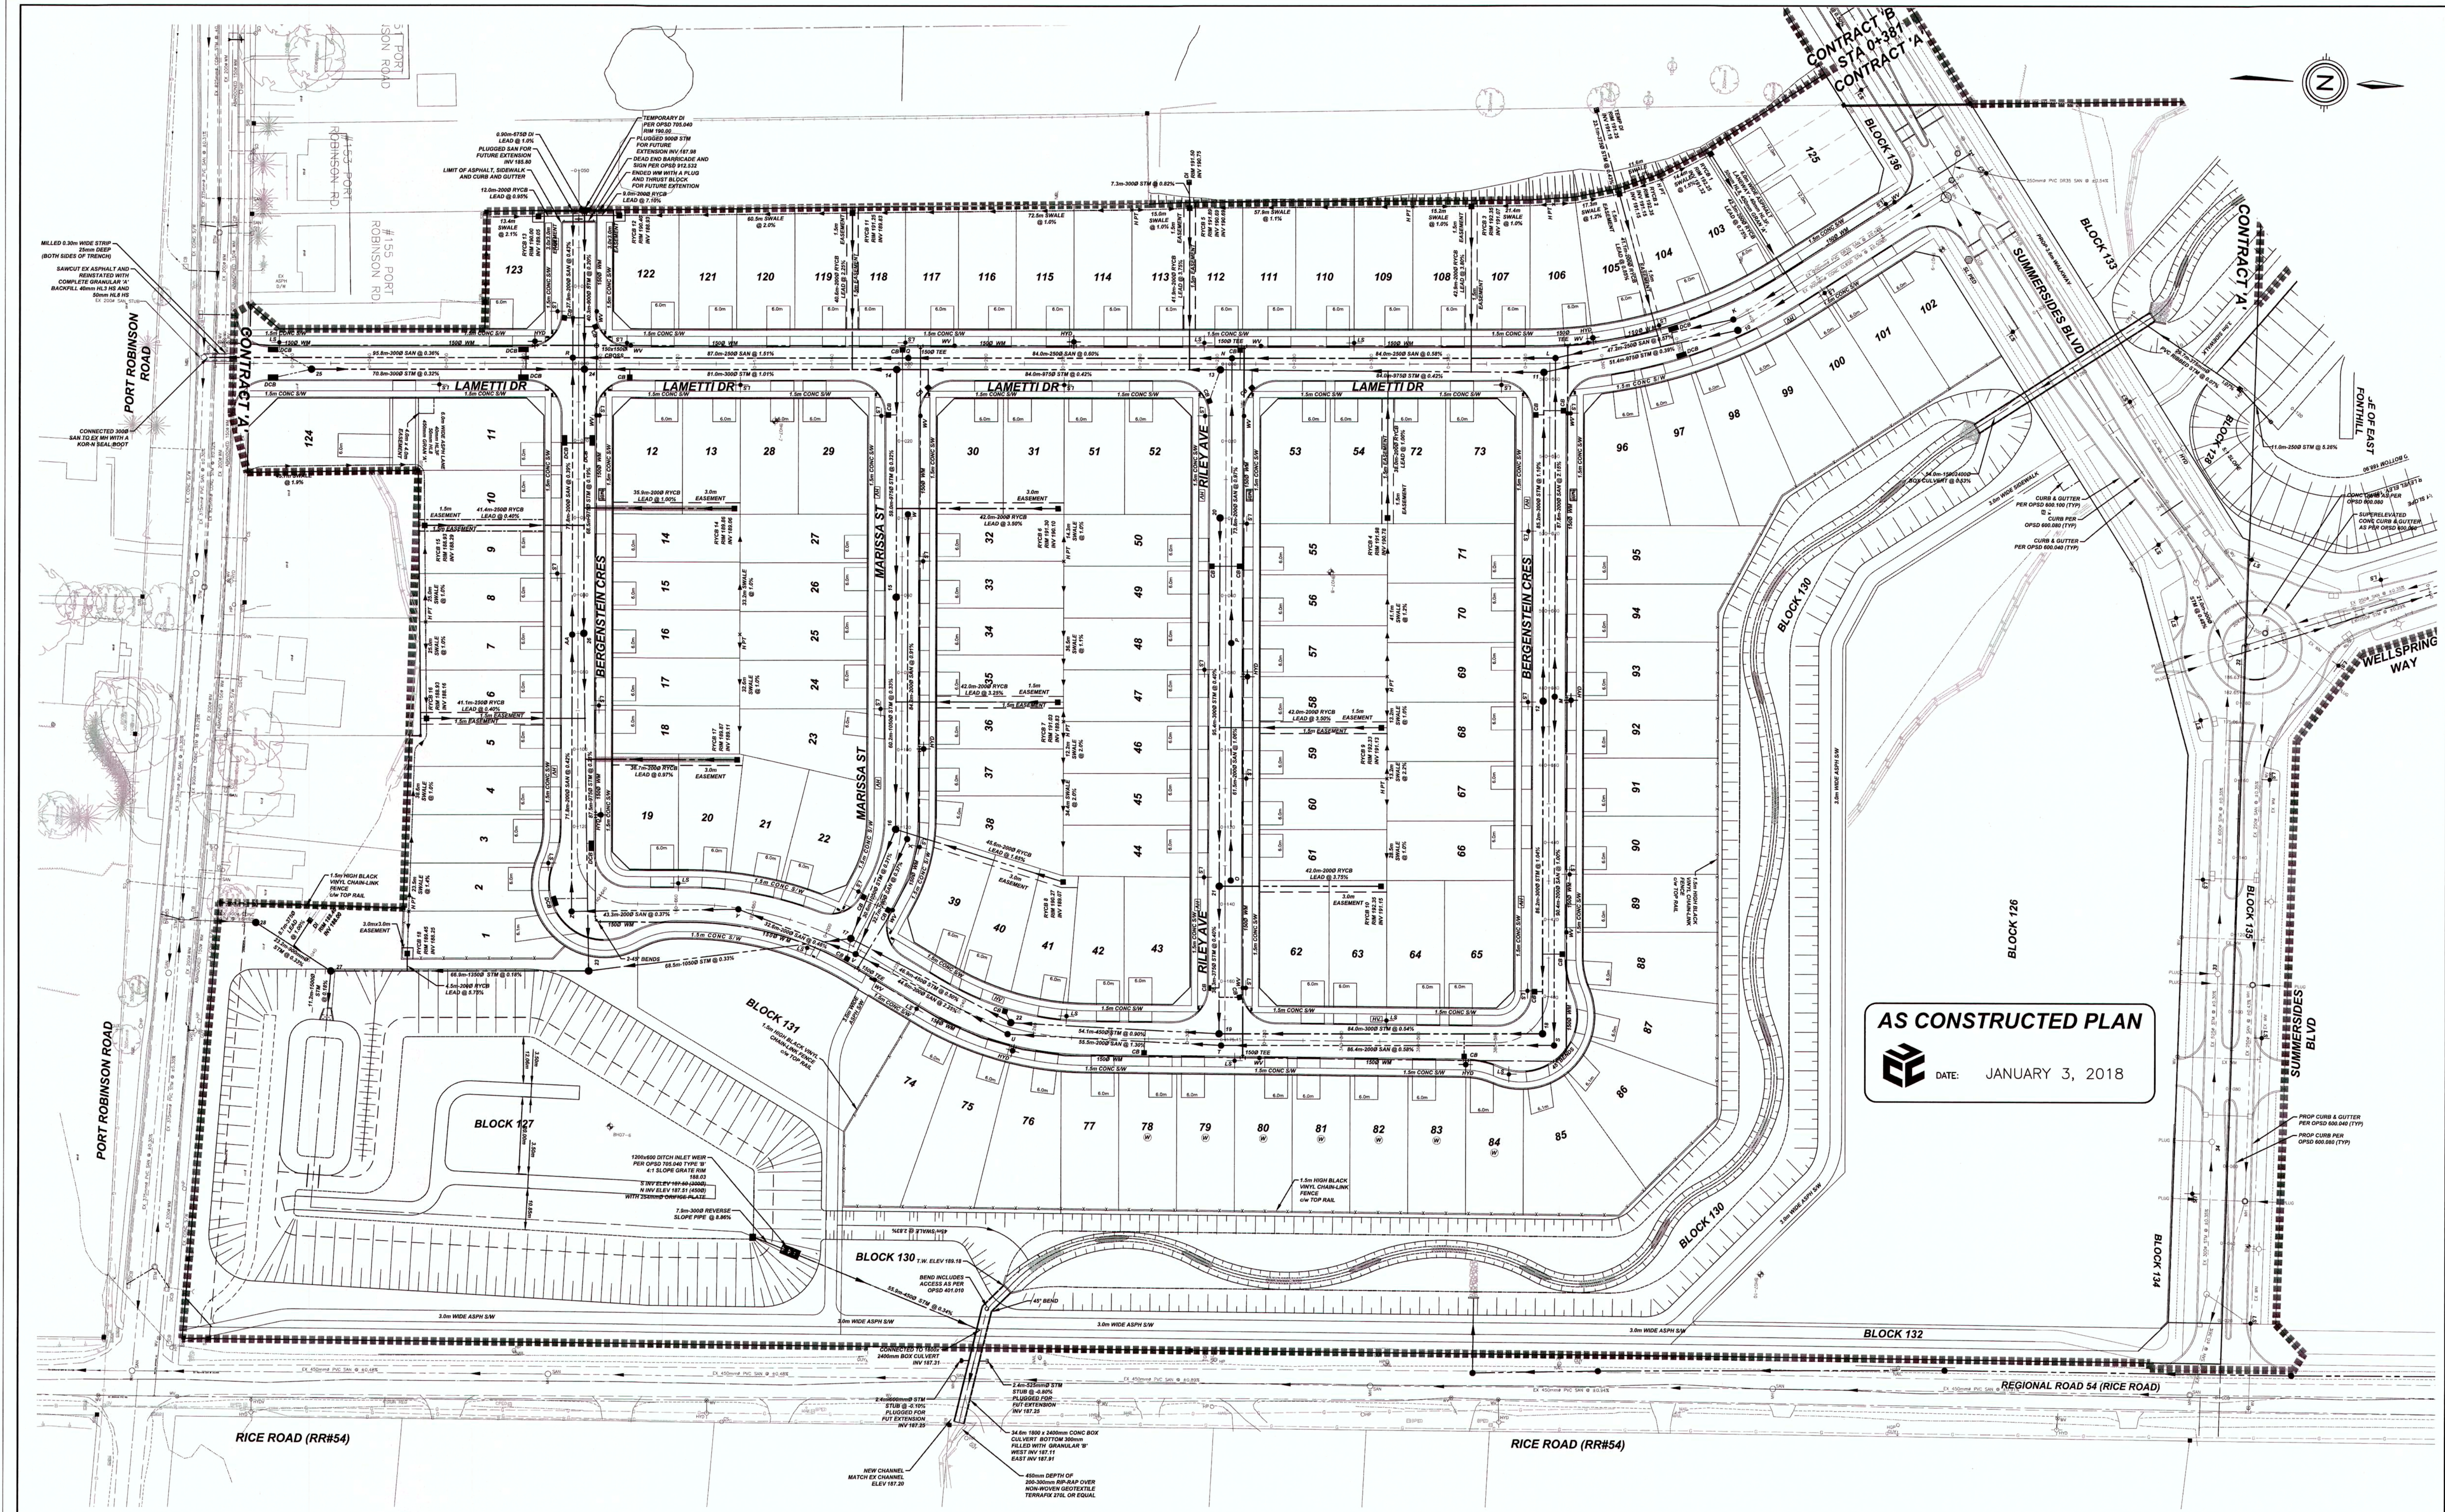

UPPER CANADA CONSULTANTS
ENGINEERS / PLANNERS

261 Mortindale Road
Niagara Falls, ON
L2W 1A1
Phone: (905) 688-9400
Fax: (905) 688-5274

OWNER
RIVER REALTY DEVELOPMENT (1976) INC.
6265 MORRISON STREET
NIAGARA FALLS, ON
L2E 7H1

RIVER ESTATES GENERAL SERVICES PLAN

CONSULTANT FILE No. 0482
DATE 2018-01-03
PRINTED 2018-01-10
SCALE 1:750 m
REF. No.
DWG No. **0482-GSP**

REV. 11